

APPLICATION FOR BUILDING PERMIT

1

WORKER'S COMPENSATION DECLARATION

I hereby affirm that I have a certificate of consent to self insure, or a certificate of Workers' Compensation Insurance, or a certified copy thereof (Sec. 3800, Lab. C.)

Policy No. _____ Company _____

☐ Certified copy is hereby furnished.

☐ Certified copy is filed with the county building inspection department.

Date _____ Applicant _____

CERTIFICATE OF EXEMPTION FROM WORKERS' COMPENSATION INSURANCE

(This section need not be completed if the permit is for one hundred dollars (\$100) or less.)

I certify that in the performance of the work for which this permit is issued, I shall not employ any person in any manner so as to become subject to the Workers' Compensation Laws.

Date _____ Applicant _____

NOTICE TO APPLICANT: If, after making this Certificate of Exemption, you should become subject to the Workers' Compensation provisions of the Labor Code, you must forthwith comply with such provisions or this permit shall be deemed revoked.

LICENSED CONTRACTORS DECLARATION

I hereby affirm that I am licensed under provisions of Chapter 9 (commencing with Section 7000) of Division 3 of the Business and Professions Code, and my license is in full force and effect.

License Number _____ Lic. Class _____

Contractor _____ Date _____

☐ I am exempt under Sec. _____

B.&P.C. for this reason _____

Date: _____

Signature _____

☒ I, as owner of the property, or my employees with wages as their sole compensation, will do the work and the structure is not intended or offered for sale (Section 7044, Business and Professions Code.)

☐ I, as owner of the property, am exclusively contracting with licensed contractors to construct the project (Section 7044, Business and Professions Code.)

CONSTRUCTION LENDING AGENCY

I hereby affirm that there is a construction lending agency for the performance of the work for which this permit is issued (Sec. 3097, Civ. C.)

Lender's Name _____

Lender's Address _____

I certify that I have read this application and state under penalty of perjury that the above information is correct. I agree to comply with all county ordinances and State laws relating to building construction, and hereby authorize representatives of this County to enter upon the above-mentioned property for inspection purposes.

Signature of Applicant or Agent _____ Date _____

COUNTY OF LOS ANGELES

FOR APPLICANT TO FILL IN

BUILDING ADDRESS 523 N. Herbert Ave	
CITY L.A.	ZIP 90063
SIZE OF LOT	NO. OF BLDGS. NOW ON LOT
TRACT	BLOCK
LOT NO.	
ASSESSOR MAP BOOK	PAGE
PARCEL	
OWNER Maria Ramirez	TEL NO.
ADDRESS 523 N. Herbert Ave	
CITY L.A.	ZIP
ARCHITECT OR ENGINEER	TEL NO. 780-1713
ADDRESS	
CONTRACTOR Owner/Builder	TEL NO.
ADDRESS	
CITY	LIC. CLASS
SQ. FT. SIZE 168	NO. OF STORIES
NO. OF FAMILIES	
DESCRIPTION OF WORK Room addition	
14x12	
USE OF EXISTING BLDG.	
APPLICANT (PRINT)	TEL NO.
ADDRESS	
<p>WILL THE APPLICANT OR FUTURE BUILDING OCCUPANT HANDLE A HAZARDOUS MATERIAL OR A MIXTURE CONTAINING A HAZARDOUS MATERIAL EQUAL TO OR GREATER THAN THE AMOUNTS SPECIFIED ON THE HAZARDOUS MATERIALS INFORMATION GUIDE?</p> <p>YES <input type="checkbox"/> NO <input type="checkbox"/></p> <p>WILL THE INTENDED USE OF THE BUILDING BY THE APPLICANT OR FUTURE BUILDING OCCUPANT REQUIRE A PERMIT FOR CONSTRUCTION OR MODIFICATION FROM THE SOUTH COAST AIR QUALITY MANAGEMENT DISTRICT (SCAQMD) SEE PERMITTING CHECKLIST FOR GUIDELINES.</p> <p>YES <input type="checkbox"/> NO <input type="checkbox"/></p> <p>I HAVE READ THE HAZARDOUS MATERIALS INFORMATION GUIDE AND THE SCAQMD PERMITTING CHECKLIST. I UNDERSTAND MY REQUIREMENTS UNDER THE LOS ANGELES COUNTY CODE, TITLE 2, CHAPTER 2.20 SECTIONS 2.20.100 THROUGH 2.20.140 CONCERNING HAZARDOUS MATERIALS REPORTING AND FOR OBTAINING A PERMIT FROM THE SCAQMD.</p> <p>OWNER OR AGENT _____</p>	
P.C. FEE 125.10	PERMIT FEE 148.18
ISSUANCE FEE 17.10	
INVESTIGATION FEE	TOTAL FEE 165.28

BUILDING AND SAFETY

BUILDING ADDRESS 523 N. Herbert	
LOCALITY L.A.	
NEAREST CROSS ST. Hammel	
USE ZONE	MAP NO.
SPECIAL CONDITIONS	
WITHIN 1000 FT. OF SCHOOL?	YES <input type="checkbox"/> NO <input type="checkbox"/>
DISTRICT 6	GROUP R3
TYPE CONST. 3	FIRE ZONE 3
PROCESSED BY Rose	
STATISTICAL CLASSIFICATION CLASS NO. 21	DWELL UNITS
APT	CONDO
REQUIRED SET BACK	YARD
HWY	TOTAL SETBACK FROM PROP LINE
EXIST WIDTH	
FRONT P L	
SIDE P L	P23
SEWER MAP	
BK	PG
VALUATION \$10,000	
\$	
LDMA P/C #	
LDMA Perm #	
FINAL DATE 6/29/96	
FINAL BY [Signature]	

VALIDATION

01*12510
*12510
02-7016
10-59
03-29-93
\$1
P1
01*16528
*16528
02-7017
10-59
03-29-93
\$1

INSPECTOR COPY

SEE REVERSE FOR EXPLANATORY LANGUAGE

WORKER'S COMPENSATION DECLARATION

I hereby affirm that I have a certificate of consent to self insure, or a certificate of Worker's Compensation Insurance, or a certified copy thereof (Sec. 3800 Lab. C.)

Policy No. _____ Company _____

☐ Certified copy is hereby furnished.

☐ Certified copy is filed with the county building inspection department.

Date _____ Applicant _____

CERTIFICATE OF EXEMPTION FROM WORKERS' COMPENSATION INSURANCE

(This section need not be completed if the work involved by the permit is for one hundred dollars (\$100) or less.)

I certify that in the performance of the work for which this permit is issued, I shall not employ any person in any manner so as to become subject to the Workers' Compensation Laws.

Date _____ Applicant _____

NOTICE TO APPLICANT: If, after making this Certificate of Exemption, you should become subject to the Workers' Compensation provisions of the Labor Code, you must forthwith comply with such provisions or this permit shall be deemed revoked.

LICENSED CONTRACTORS DECLARATION

I hereby affirm that I am licensed under provisions of Chapter 9 (commencing with Section 7000) of Division 3 of the Business and Professions Code, and my license is in full force and effect.

License Number _____ Lic. Class _____

Contractor _____ Date _____

☐ I am exempt under Sec. _____

B.&P.C. for this reason _____

Date: _____

Signature _____

☐ Exemption for Reg. Maint. Elect.

SINGLE FAMILY HOME OWNER-BUILDER DECLARATION

I hereby affirm that I am exempt from the Contractor's License Law for the following reason (Section 7031.5, Business and Professions Code):

☐ I, as owner of the property, will do the work and the structure is not intended or offered for sale (Section 7044, Business and Professions Code).

CONSTRUCTION LENDING AGENCY

I hereby affirm that there is a construction lending agency for the performance of the work for which this permit is issued (Sec. 3097, Civ. C.)

Lender's Name _____

Lender's Address _____

I certify that I have read this application and under penalty of perjury state that the above information is correct. I agree to comply with all County ordinances and State laws regulating Electrical wiring, and hereby authorize representatives of this County to enter upon the above-mentioned property for inspection purposes.

Maria Ramirez 4-30-93
SIGNATURE OF PERMITTEE DATE

20-0019 DPW (12-91)
76A663

APPLICATION FOR ELECTRICAL PERMIT

COUNTY OF LOS ANGELES

DEPT. OF PUBLIC WORKS

BUILDING AND SAFETY DIV.

FOR APPLICANT TO FILL IN				JOB ADDRESS	
NO.	EACH	FEE			
New Residential Bldgs. & Pools			523 N. Herbert		
1 & 2 -Family, Sq. Ft.			LOCALITY ECLA		
Multi-family Sq. Ft.			NEAREST CROSS ST. Hammel		
Residential Swimming Pools			ASSESSOR MAP BOOK PAGE PARCEL		
Outlets: Rec. 3 Light 1 Sw. 2	6	1.20	OWNER OR FIRM NAME MARIA RAMIREZ		
Total No. 6		7.20	MAIL ADDRESS 523 N. HERBERT AVE		
Lighting Fixtures 1	1	1.20	CITY Los Angeles CA Tel. No. 780 M15		
Total No. 1		1.20	PLAN CHECK APPLICANT		
RESIDENTIAL APPLIANCES NOT OVER 3 HP.			ADDRESS		
OTHER APPLIANCES NOT OVER 3 HP.			CITY Tel. No.		
Power Apparatus & Large Appliances			PERMIT APPLICANT		
Size & Type HP, KW, KVA, or KVAR			ADDRESS		
Over 3 to 10 Incl.			CITY Tel. No.		
Over 10 to 50 Incl.			LICENSE OR REG. NUMBER Class.		
Over 50 to 100 Incl.			DISTRICT NO. 6 PROCESSED BY E.B.		
Over 100			FINAL DATE 6/28/96		
Services, Swbd., MCC & Panelboards			FINAL BY [Signature]		
0 - 399 Amp. Under 600 V			50.00		
400 - 1000 Amp. Under 600 V			25.50		
Over 1000 Amp. or Over 600 V			2450		
BRANCH CIRCUIT FEES					
15A, or 20A, 120V, Lighting or Recept.					
1 To 10 Branch Circuits					
11 To 40 Branch Circuits					
41 Or More Branch Circuits					
15A, 20A, 208V To 277V Lighting Br. Circuits					
Temp. Power Pole & Appurtenances					
Sign with One Branch Circuit					
Additional Sign Branch Circuits					
Misc. Conduits & Conductors					
Other (See Complete Fee Schedule)					
PERMIT FEE (Sub-Total)			8.40		
PLAN CHECKING FEE					
PERMIT ISSUING FEE			17.10		
TOTAL FEE			25.50		

P2

01 *2550

*2550 8

Q1 2-7555


13-27

05-07-93

81

SEE REVERSE FOR EXPLANATORY LANGUAGE

INSPECTOR COPY

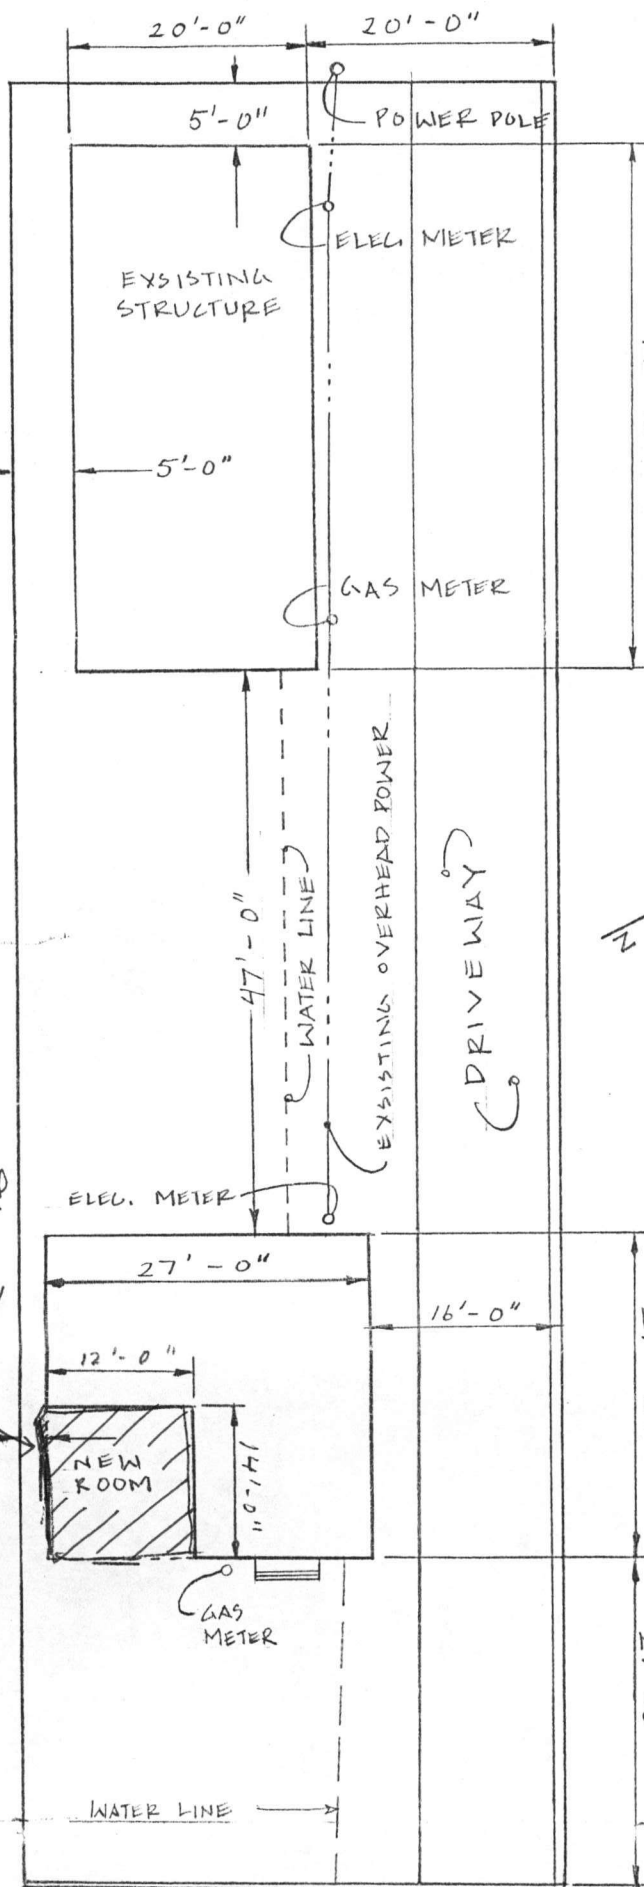

OWNER: MARIA RAMIREZ
 HOME ADDRESS: 523 N. HERBERT AVE
 LOS ANGELES CA 90063
 TELEPHONE # (213) 780 1715
 DATE: 12-18-92
 X Maria Ramirez

APPLICANT'S COPY

SCALE: 1" = 16'-0"

DEPARTMENT OF REGIONAL PLANNING

CASE NUMBER: PP 42661

This plot plan is APPROVED subject to the requirements of Los Angeles County Code and to the conditions noted herein. It is applicable only as specifically noted and must be used prior to any change in ordinance requirements or within two years. Such approval shall not be construed to permit the violation of any provision of any County Ordinance or State law.

Signature: *Paul Ch...*

Date:

MAR 23 1993

Approved for new room addition shown in red. Two uncovered parking spaces required for existing SFRs!

PLOT PLAN

Area available for 4 spaces

1523 HERBERT AVE

Block permit # 7017
3/29/93

1-4-93